



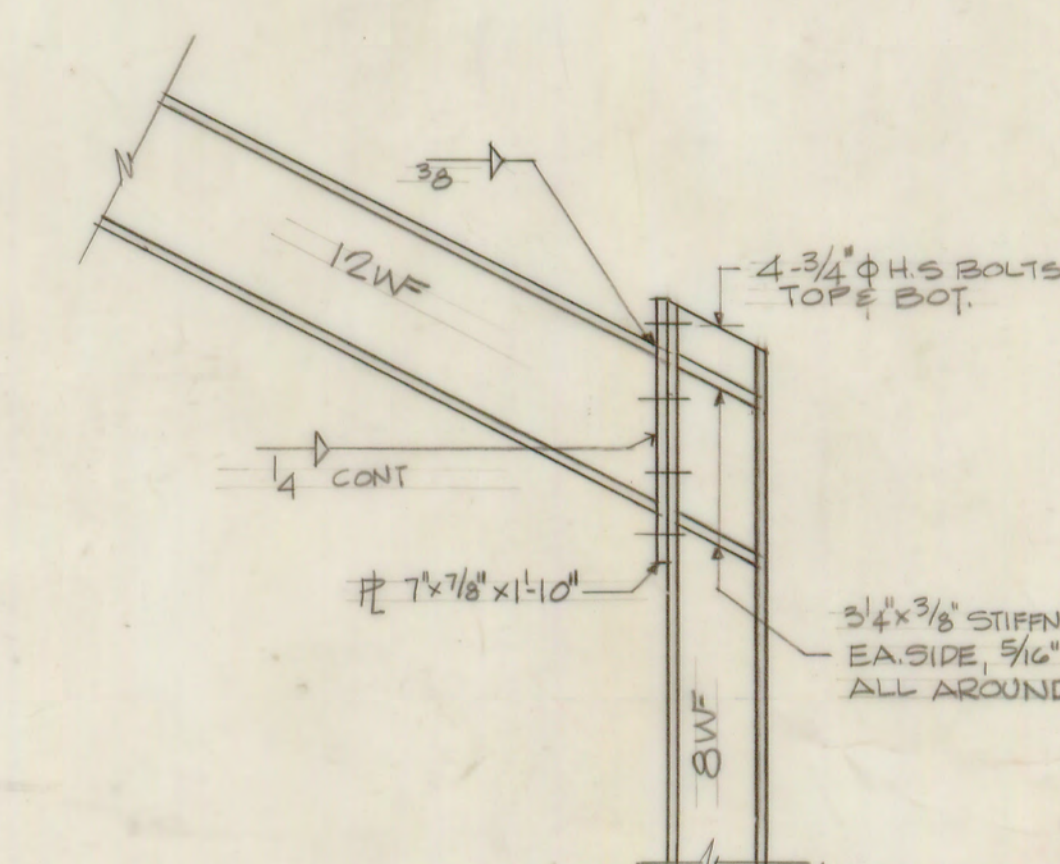

SCALE 14" = 1'-0"


①—CONTRACTOR FURNISHED & INSTALLED.
②—GOV'T. FURNISHED & INSTALLED.
③—GOV'T. FURNISHED & CONTRACTOR INSTALLED (SEE SPECIFICATIONS).

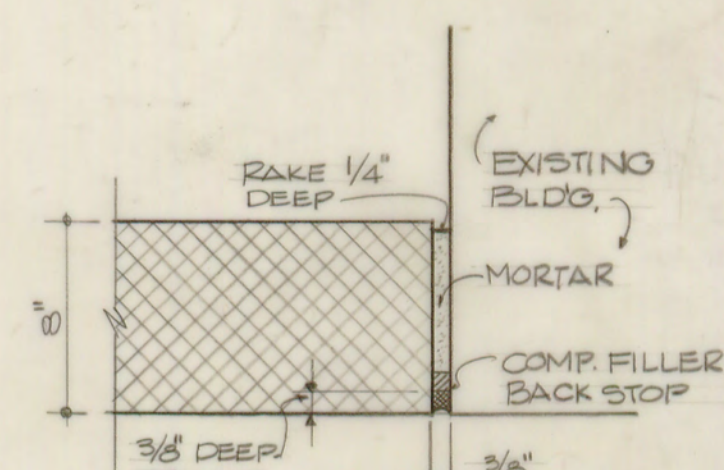

DETAIL

4	A-4
	A-4

 $3/4" = 1'-0"$

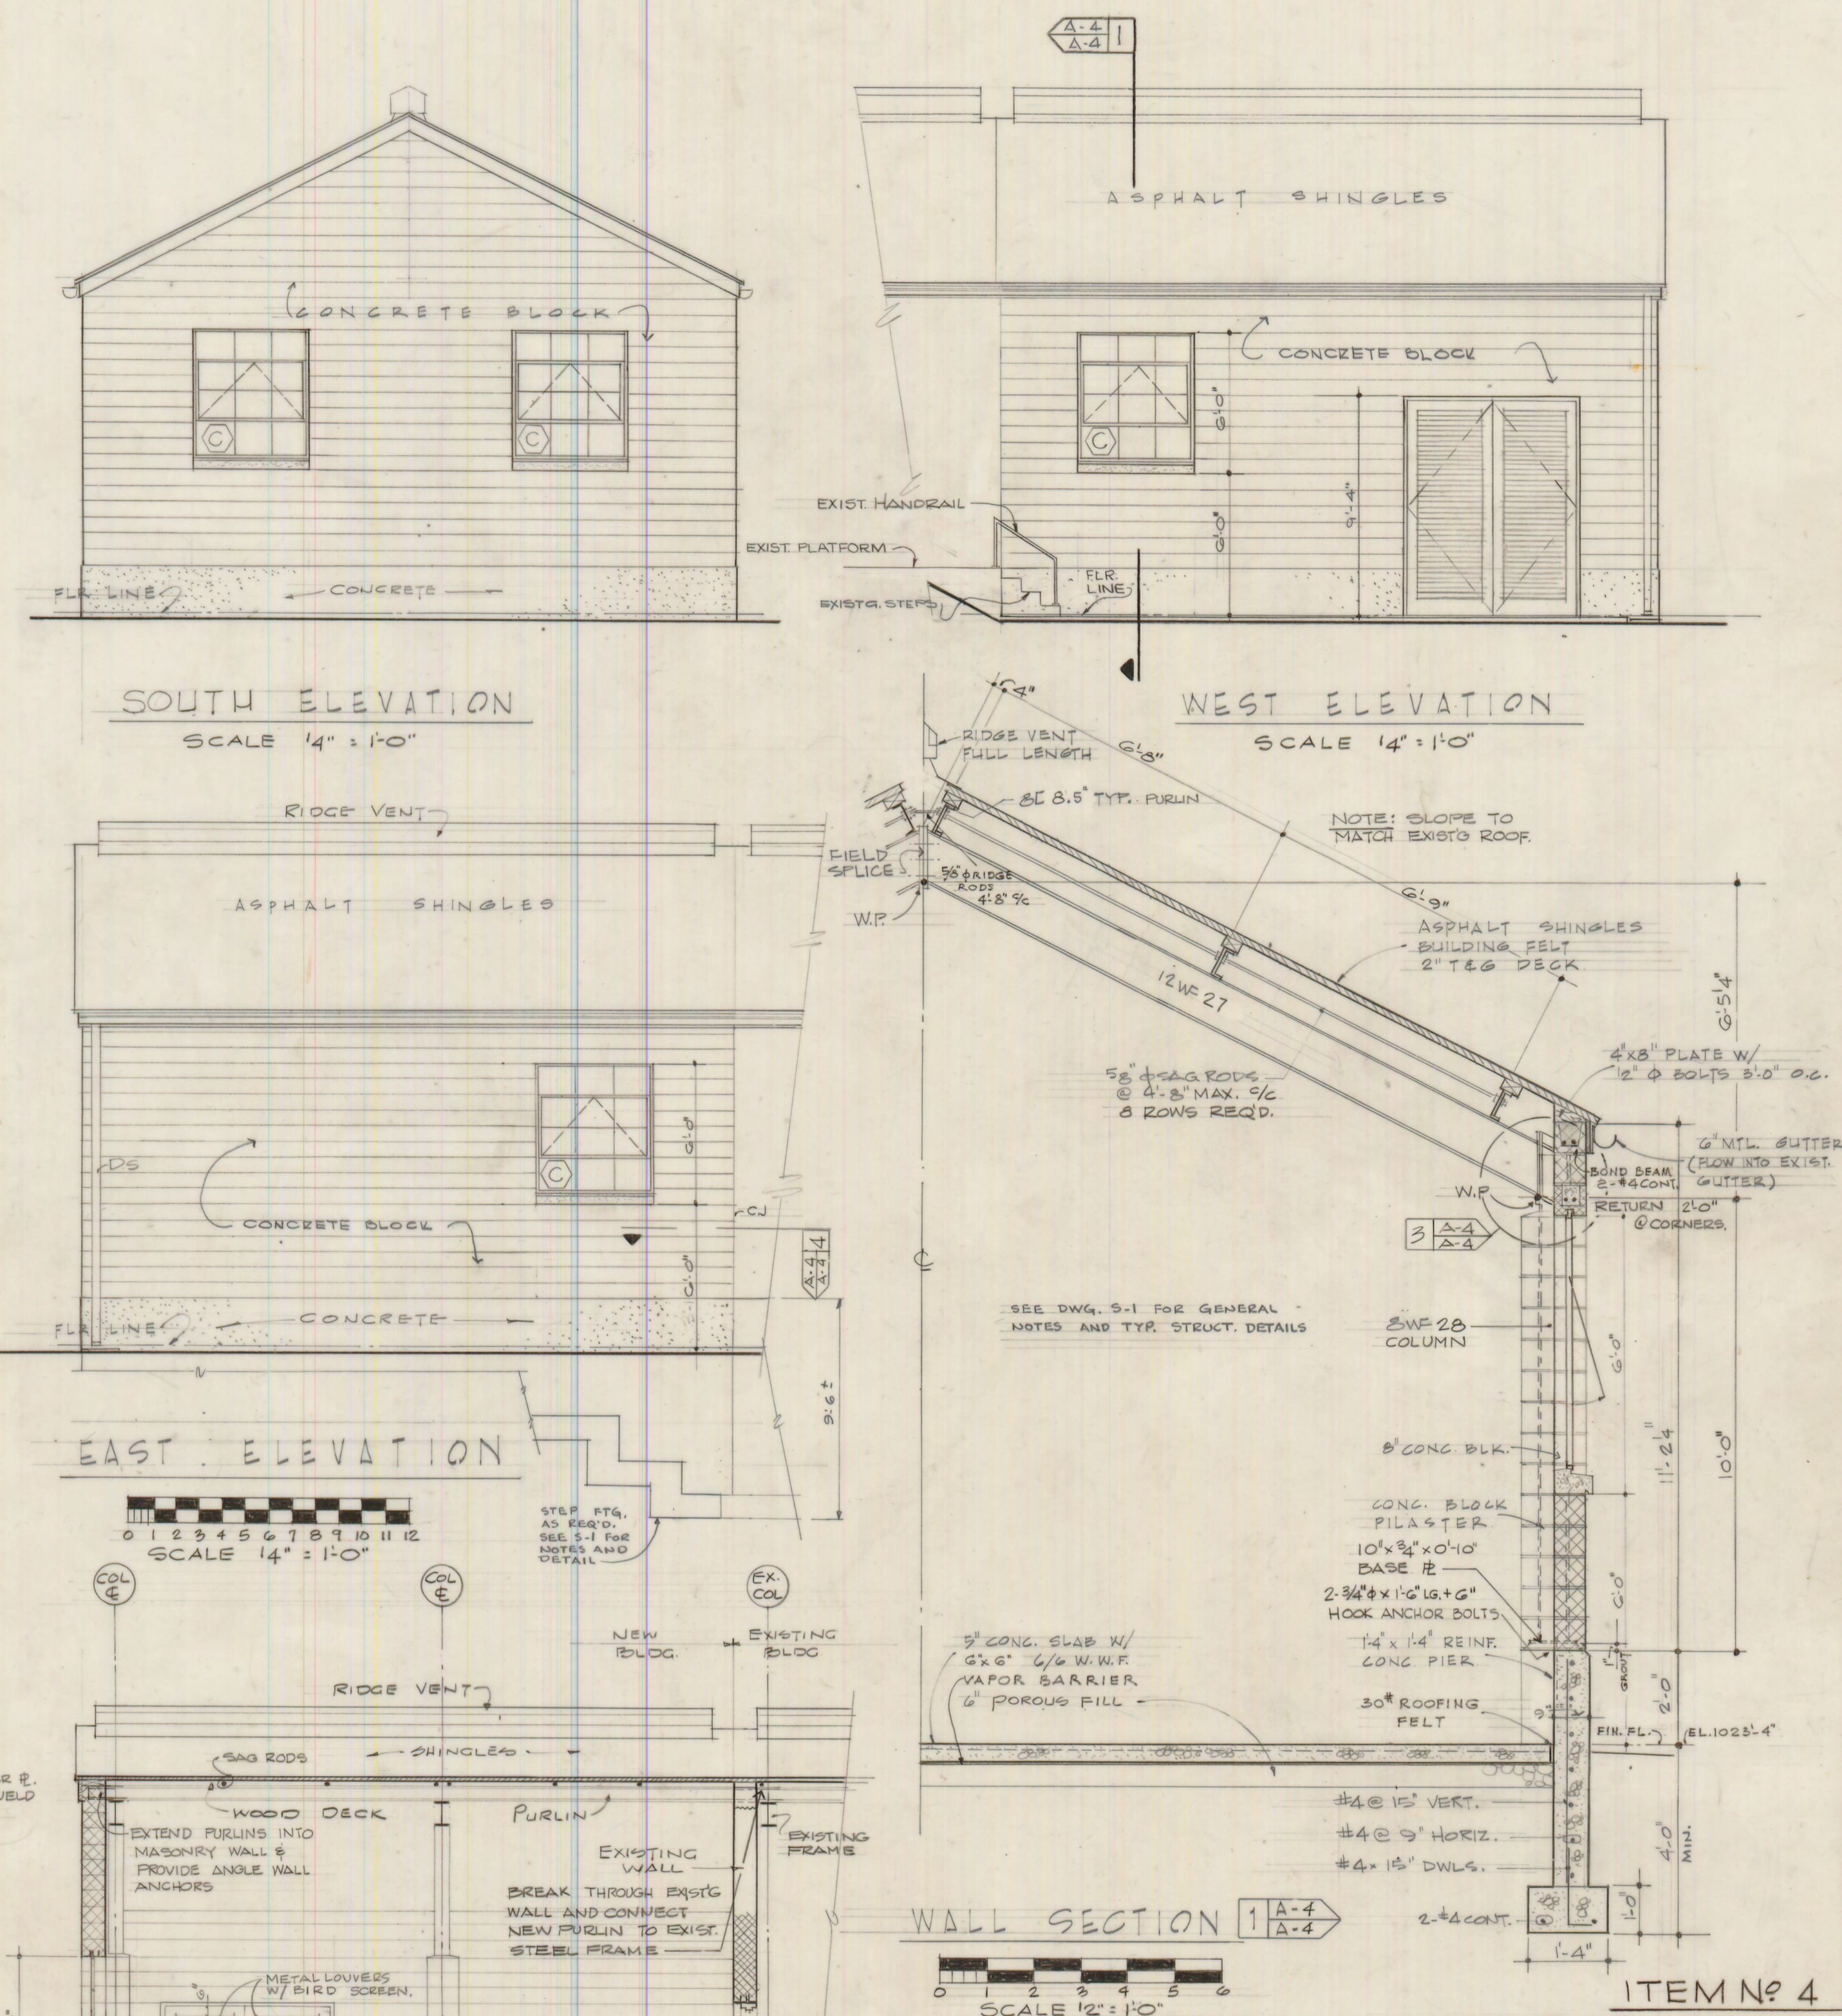

SECTION
SCALE 1" = 1'-0"

FEB 72		As Constructed		EGH	
JUNE 70		REV. PER AMT. NO 1 DATED 28 APRIL 1970		J.E.	
REVISION	DATE	DESCRIPTION			BY
DALTON • DALTON • LITTLE ARCHITECTS • ENGINEERS		U.S. ARMY ENGINEER DISTRICT, LOUISVILLE CORPS OF ENGINEERS LOUISVILLE, KENTUCKY			
DESIGNED: J.F.		RAVENNA ARMY AMMUNITION PLANT RAVENNA, OHIO REHABILITATION OF PLANT FACILITIES & UTILITIES			
DRAWN: C.S.	TRACED: C.S.				
CHECKED: J.F.					
SUBMITTED: P.C. Zwick		ADDITION TO LAUNDRY-PLAN, ELEVATIONS, SECTION			
SCALE AS SHOWN		DATE: 2-7-70 DRAWING NUMBER AS-BLT 31-01-08 A-1			

RAV-8-13