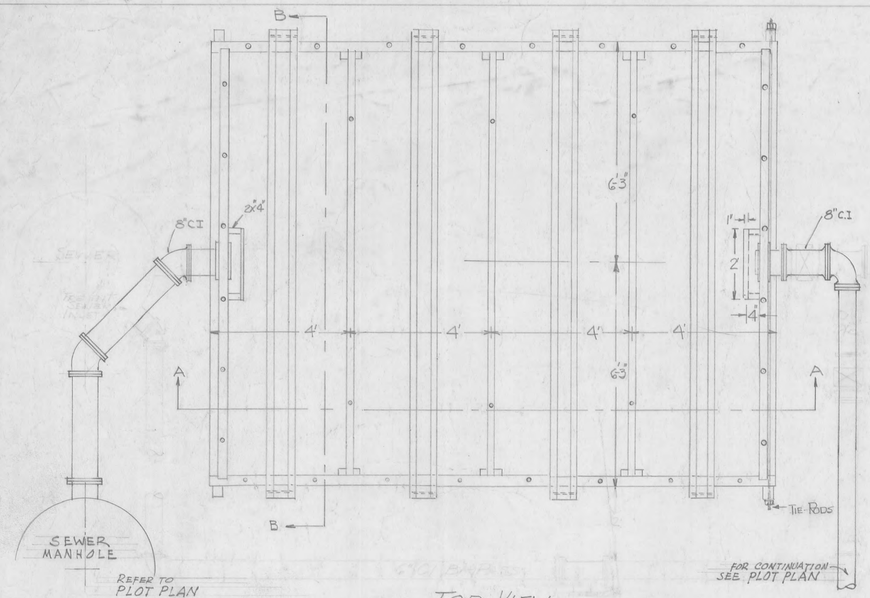

TOP VIEW

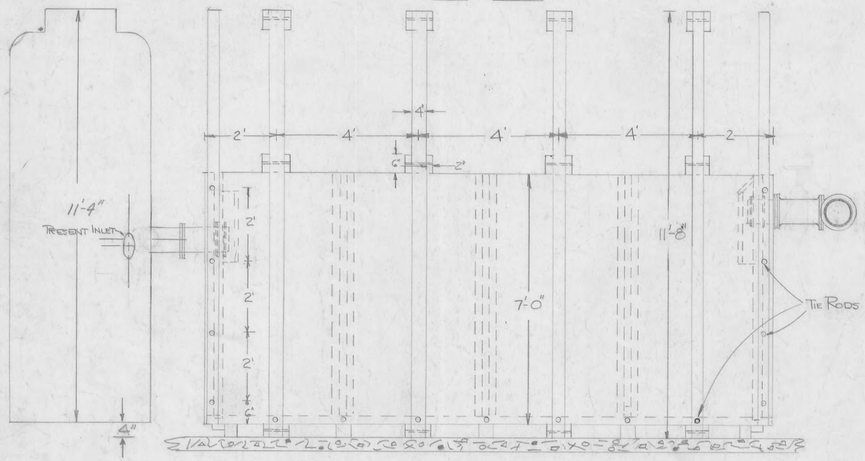

SIDE VIEW

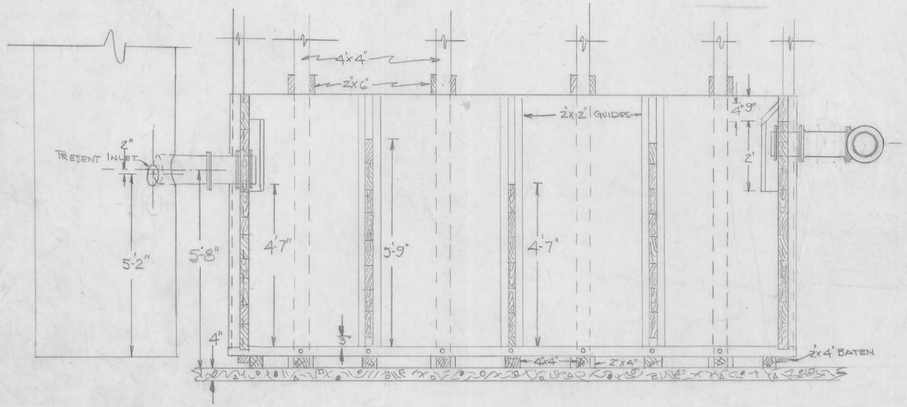

SECTION A-A

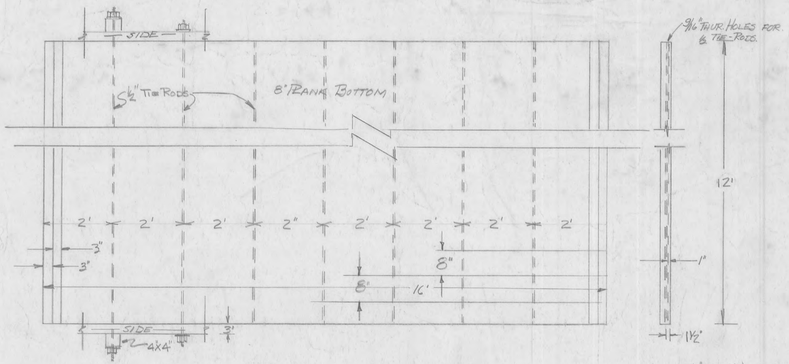

DETAIL OF BOTTOM

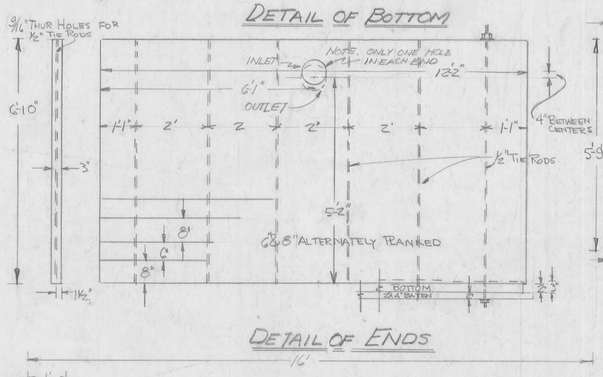

DETAIL OF ENDS

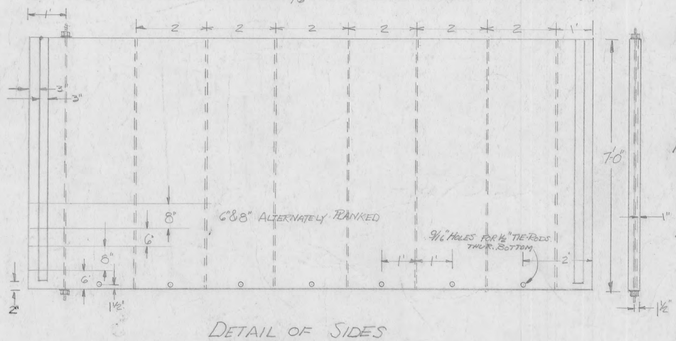

DETAIL OF SIDES

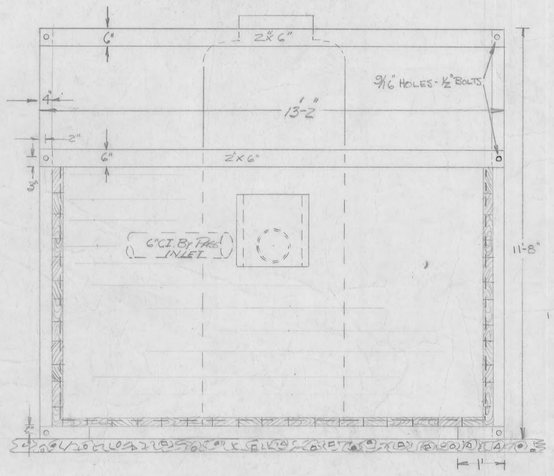

SECTION B-B

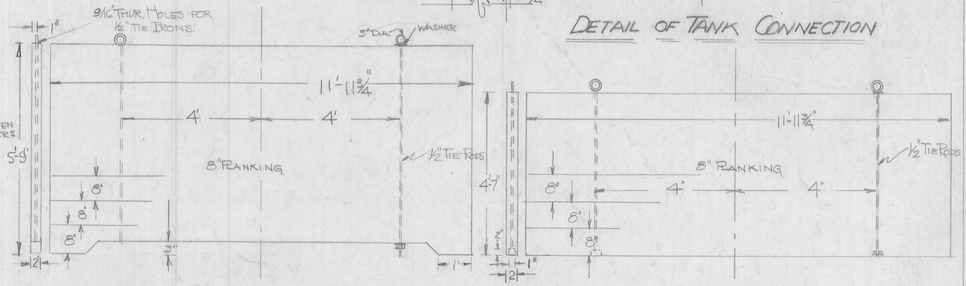

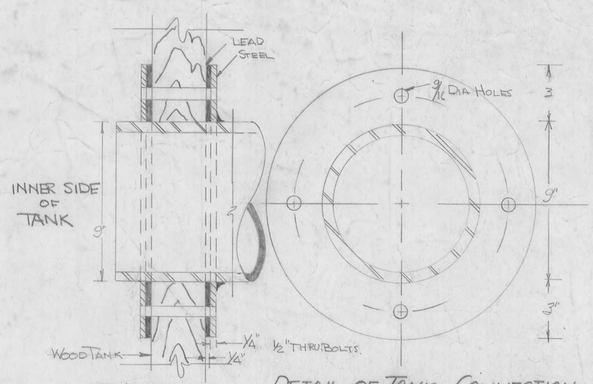

DETAIL OF TANK CONNECTION

DETAIL OF PARTITIONS

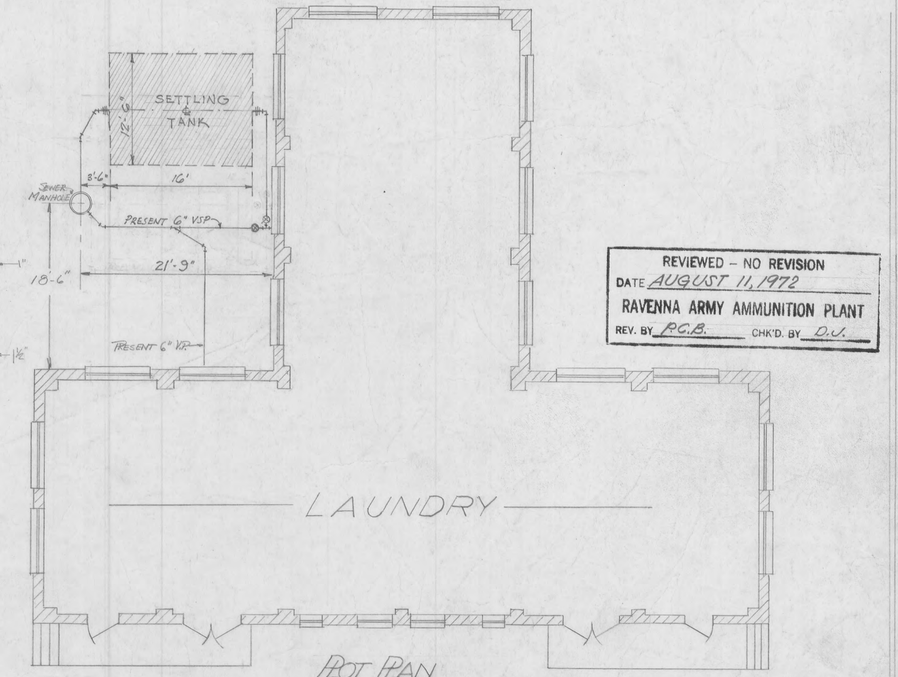

PLOT PLAN
SCALE 1/8"=1'-0"

REVIEWED – NO REVISION
DATE AUGUST 11, 1972
RAVENNA ARMY AMMUNITION PLANT
REV. BY P.G.B. CHK'D. BY D.U.

THIS DRAWING APPLIES TO BUILDING #1037

DRAWING NUMBER CHANGED 8-14-72. FORMERLY DWG. PE-SK. 198 FOR 1969 BLDG. ADDITION SEE C.O.E. DWGS. 37-01-08 SHTS. C-9, A-4, A-8, A-9, A-10, S-1, M-7, M-10, E-3 & E-8

REVISED PLOT PLAN, TOP & SIDE VIEW AS CONSTRUCTED (2/22/45) - - - - APPROVED BY -

L. H. EATON · PLANT ENGINEER

C. H. WILLISTON · ASST. GENERAL MANAGER

O. W. MELDRUM · LT. COL. ORD. DEPT. COMMANDING

SETTLING TANK
FOR
LAUNDRY BLDG. GEORGE ROAD

THE ATLAS POWDER CO.

SCALE	DRAWN BY R.R. MADDOCKS	DATE
½" = 1'-0"	CHECKED BY C.A. MATHENY	8-18-42
WORK ORDER	1012.402	

1012.402